
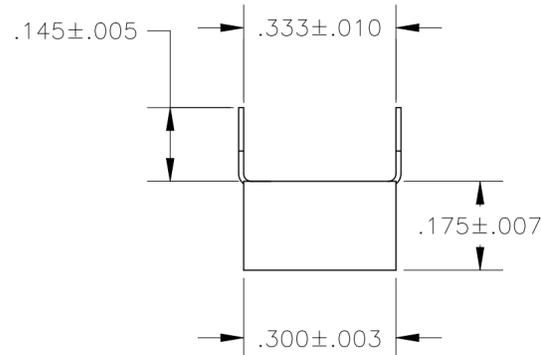
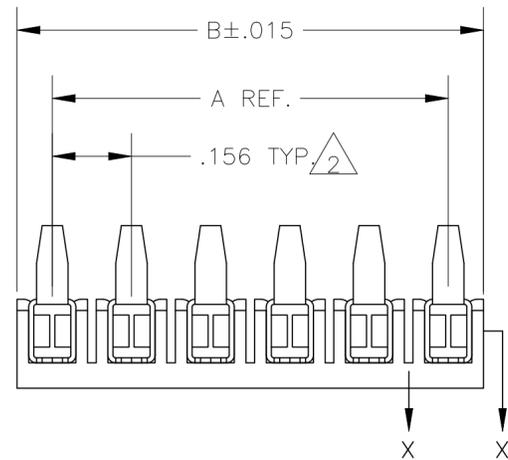
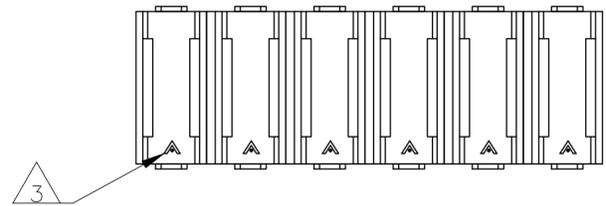
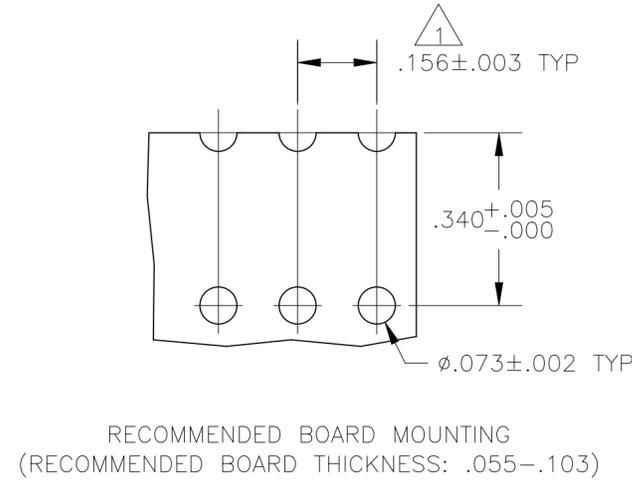


REVISIONS					
P	LTR	DESCRIPTION	DATE	DWN	APVD
M1		ECR-25-266219	22DEC2025	ABS	PS

- 1 POINT OF MEASUREMENT FOR PLATING THICKNESS (INSIDE OF BEAMS).
- 2 TOLERANCE NON-CUMULATIVE.
- 3 THE MATING END OF THE CONTACT IS IDENTIFIED BY THE LETTER "A" STAMPED ON THE RECEPTACLE BOX.
- 4 OBSOLETE PARTS: OBSOLETE CIS STREAMLINING PER D.RENAUD/D.SINISI

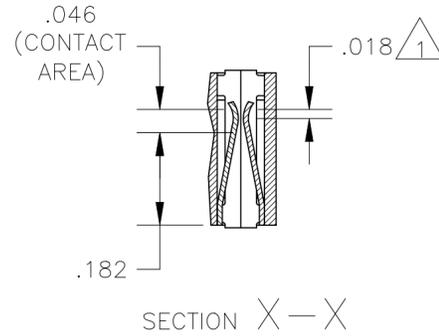

OBSOLETE 4	3.120	2.964	20	<del>2-87987-0</del>
	2.964	2.808	19	<del>1-87987-9</del>
	2.808	2.652	18	<del>1-87987-8</del>
	2.652	2.496	17	<del>1-87987-7</del>
	2.496	2.340	16	<del>1-87987-6</del>
	2.340	2.184	15	<del>1-87987-5</del>
	2.184	2.028	14	<del>1-87987-4</del>
	2.028	1.872	13	<del>1-87987-3</del>
	1.872	1.716	12	<del>1-87987-2</del>
	1.716	1.560	11	<del>1-87987-1</del>
OBSOLETE 4	1.560	1.404	10	<del>1-87987-0</del>
	1.404	1.248	9	<del>87987-9</del>
	1.248	1.092	8	<del>87987-8</del>
	1.092	.936	7	<del>87987-7</del>
	.936	.780	6	<del>87987-6</del>
OBSOLETE 4	.780	.624	5	<del>87987-5</del>
	.624	.468	4	<del>87987-4</del>
OBSOLETE 4	.468	.312	3	<del>87987-3</del>
	.312	.156	2	<del>87987-2</del>
B	A	NO OF POSN	ASSEMBLY PART NUMBER	

THIS DRAWING IS A CONTROLLED DOCUMENT.		DWN L A MAYER 17MAR86	TE Connectivity	
DIMENSIONS: INCHES		CHK P deJONG 17MAR86		
TOLERANCES UNLESS OTHERWISE SPECIFIED:		APVD P deJONG 17MAR86	NAME	
0 PLC ± - 1 PLC ± - 2 PLC ± - 3 PLC ± .005 4 PLC ± - ANGLES ± -		PRODUCT SPEC 108-25,016	ASSY, MOD I, BOARD MOUNT RECP, .156 CL, STD PRESSURE, TYPE C, FOR ROUND HOLE MOUNTING	
MATERIAL: HOUSING-FLAME RETARDANT THERMOPLASTIC, COLOR-BLACK CONTACTS-PHOS BRONZE		FINISH	APPLICATION SPEC 114-25,004	RESTRICTED TO
CONTACTS: .000079 MIN TIN		WEIGHT	SIZE A2	CAGE CODE 00779
		CUSTOMER DRAWING	DRAWING NO C=87987	SCALE 4:1
			SHEET 1 OF 1	REV M1